


8805 North 23rd Avenue

Suite 120 - 2,136 RSF

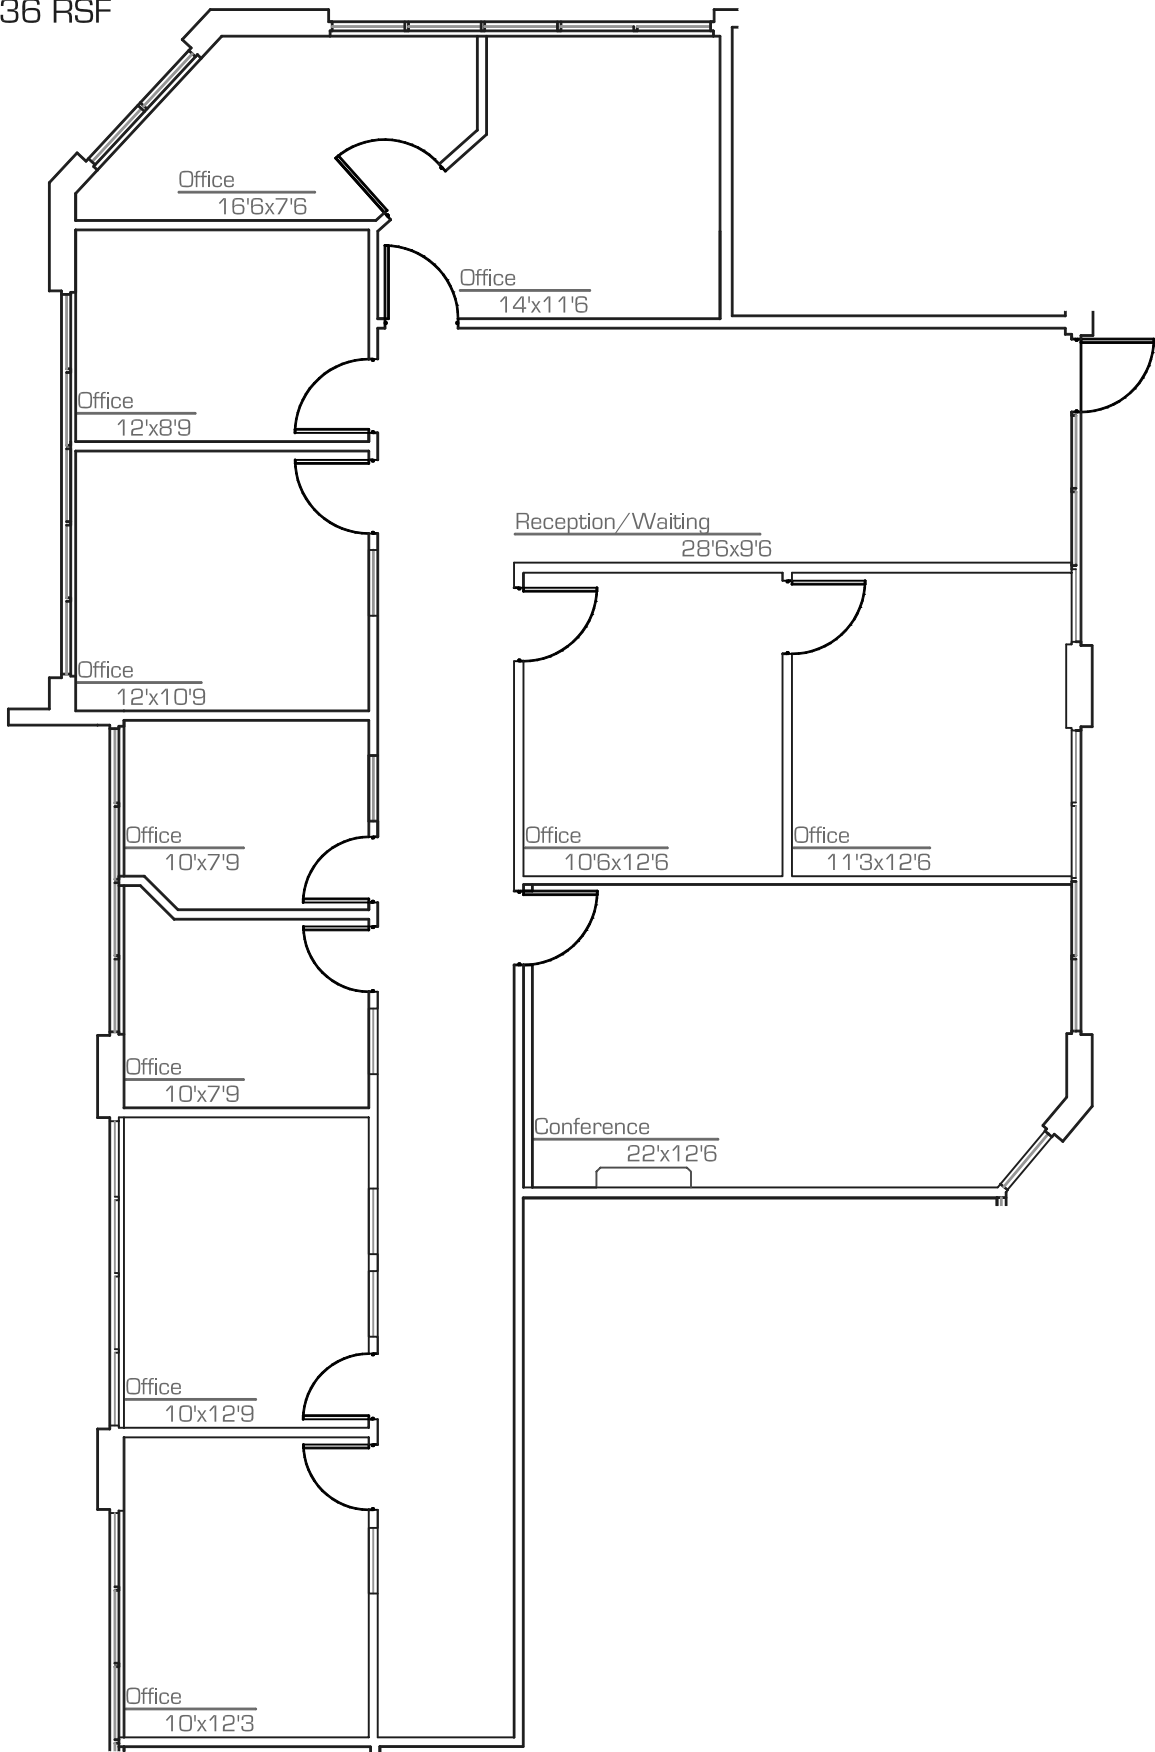


as-built

scale: nts
September.2007

*All dimensions are approximate
*All information is of general nature

precision**MEASUREMENTS**

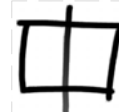

as built . space plans
architectural design

602.790.6412