


8805 North 23rd Avenue

Suite 130 - 4,852 RSF

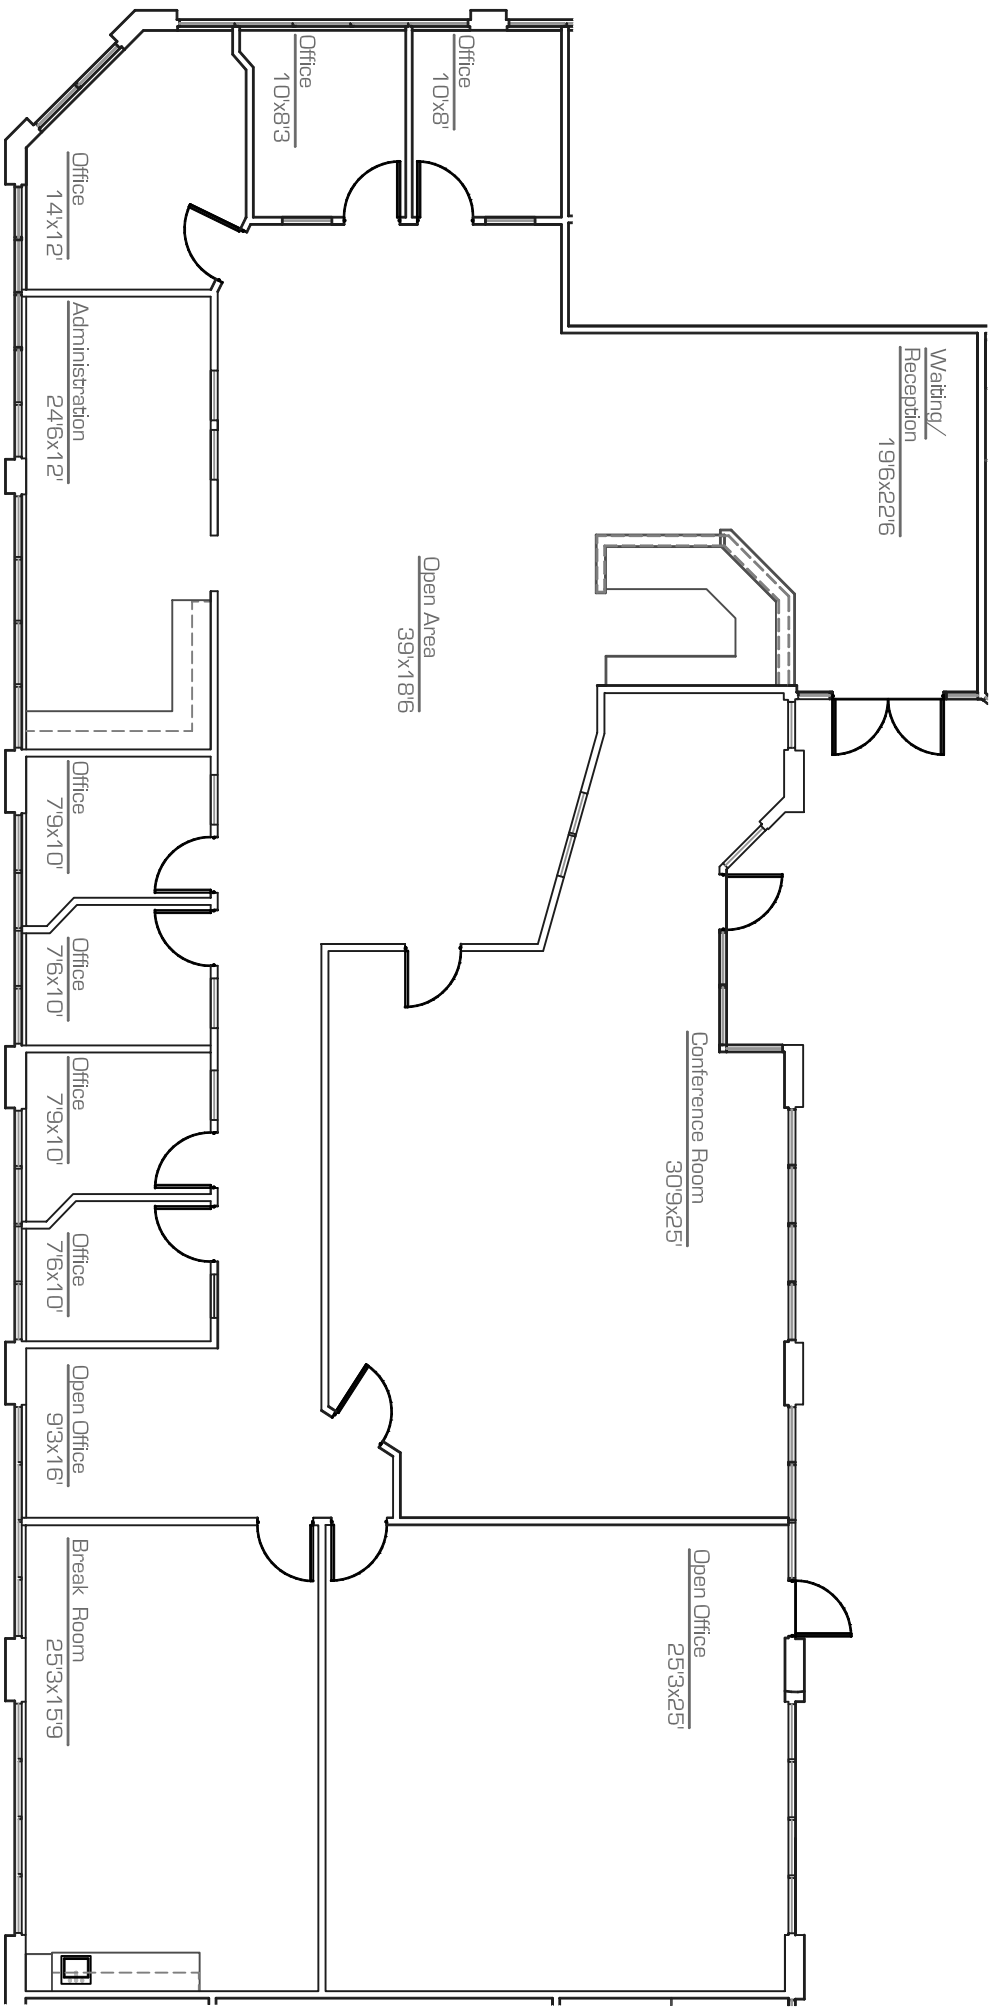

as-built

scale: nts
September.2007

* All dimensions are approximate
* All information is of general nature



precision**MEASUREMENTS**



as built, space plans
architectural design
602.790.6412