


# 8805 North 23rd Avenue

Suite 160 - 1,134 RSF

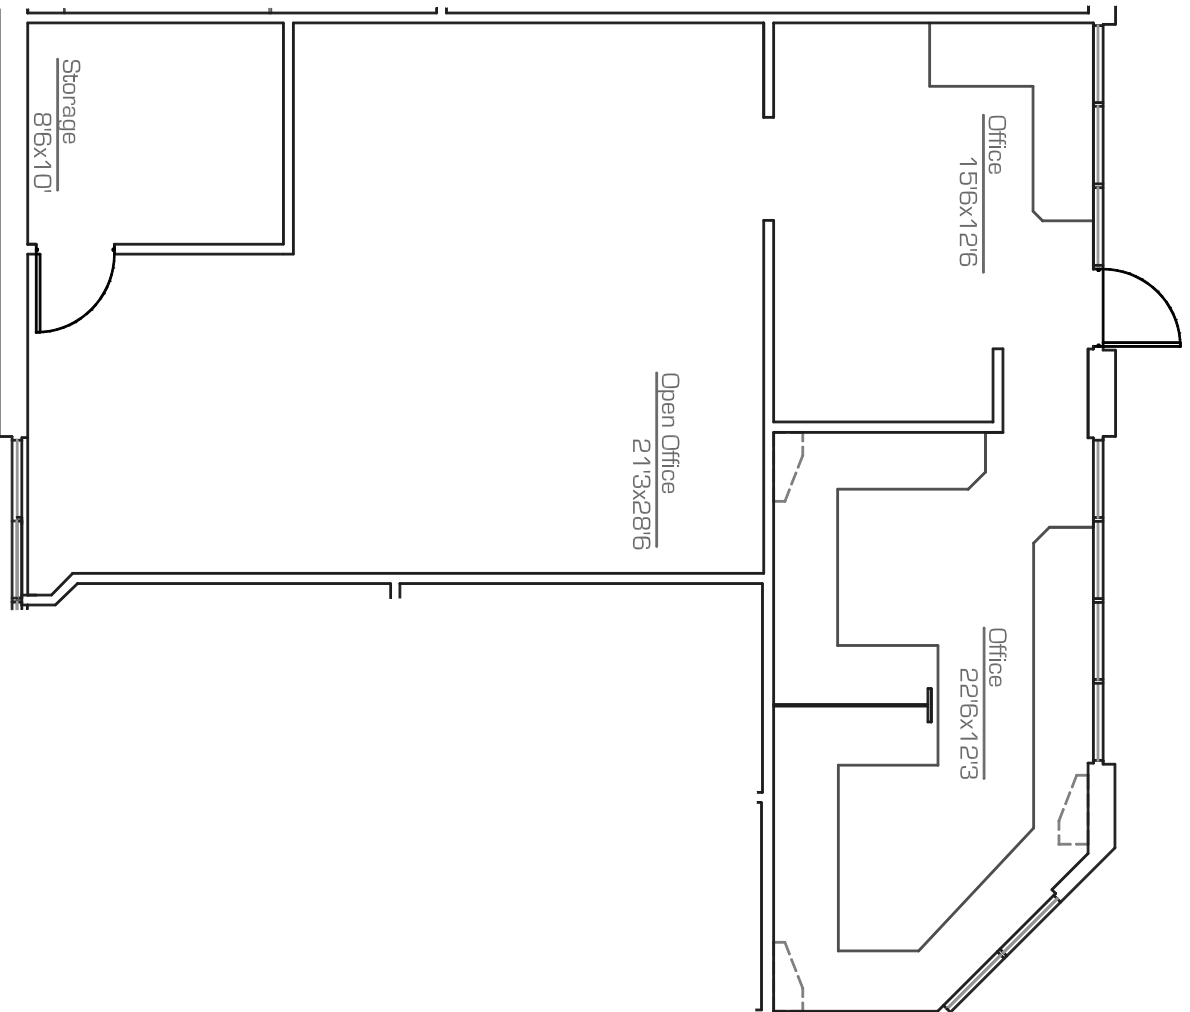

**as-built**

scale: nts  
September.2007

\* All dimensions are approximate  
\* All information is of general nature



precision**MEASUREMENTS**

as built, space plans  
architectural design

602.790.6412

