


# 8805 N 23rd Avenue

Suite 180 - 2,665 RSF

Suite 190 - 2,590 RSF

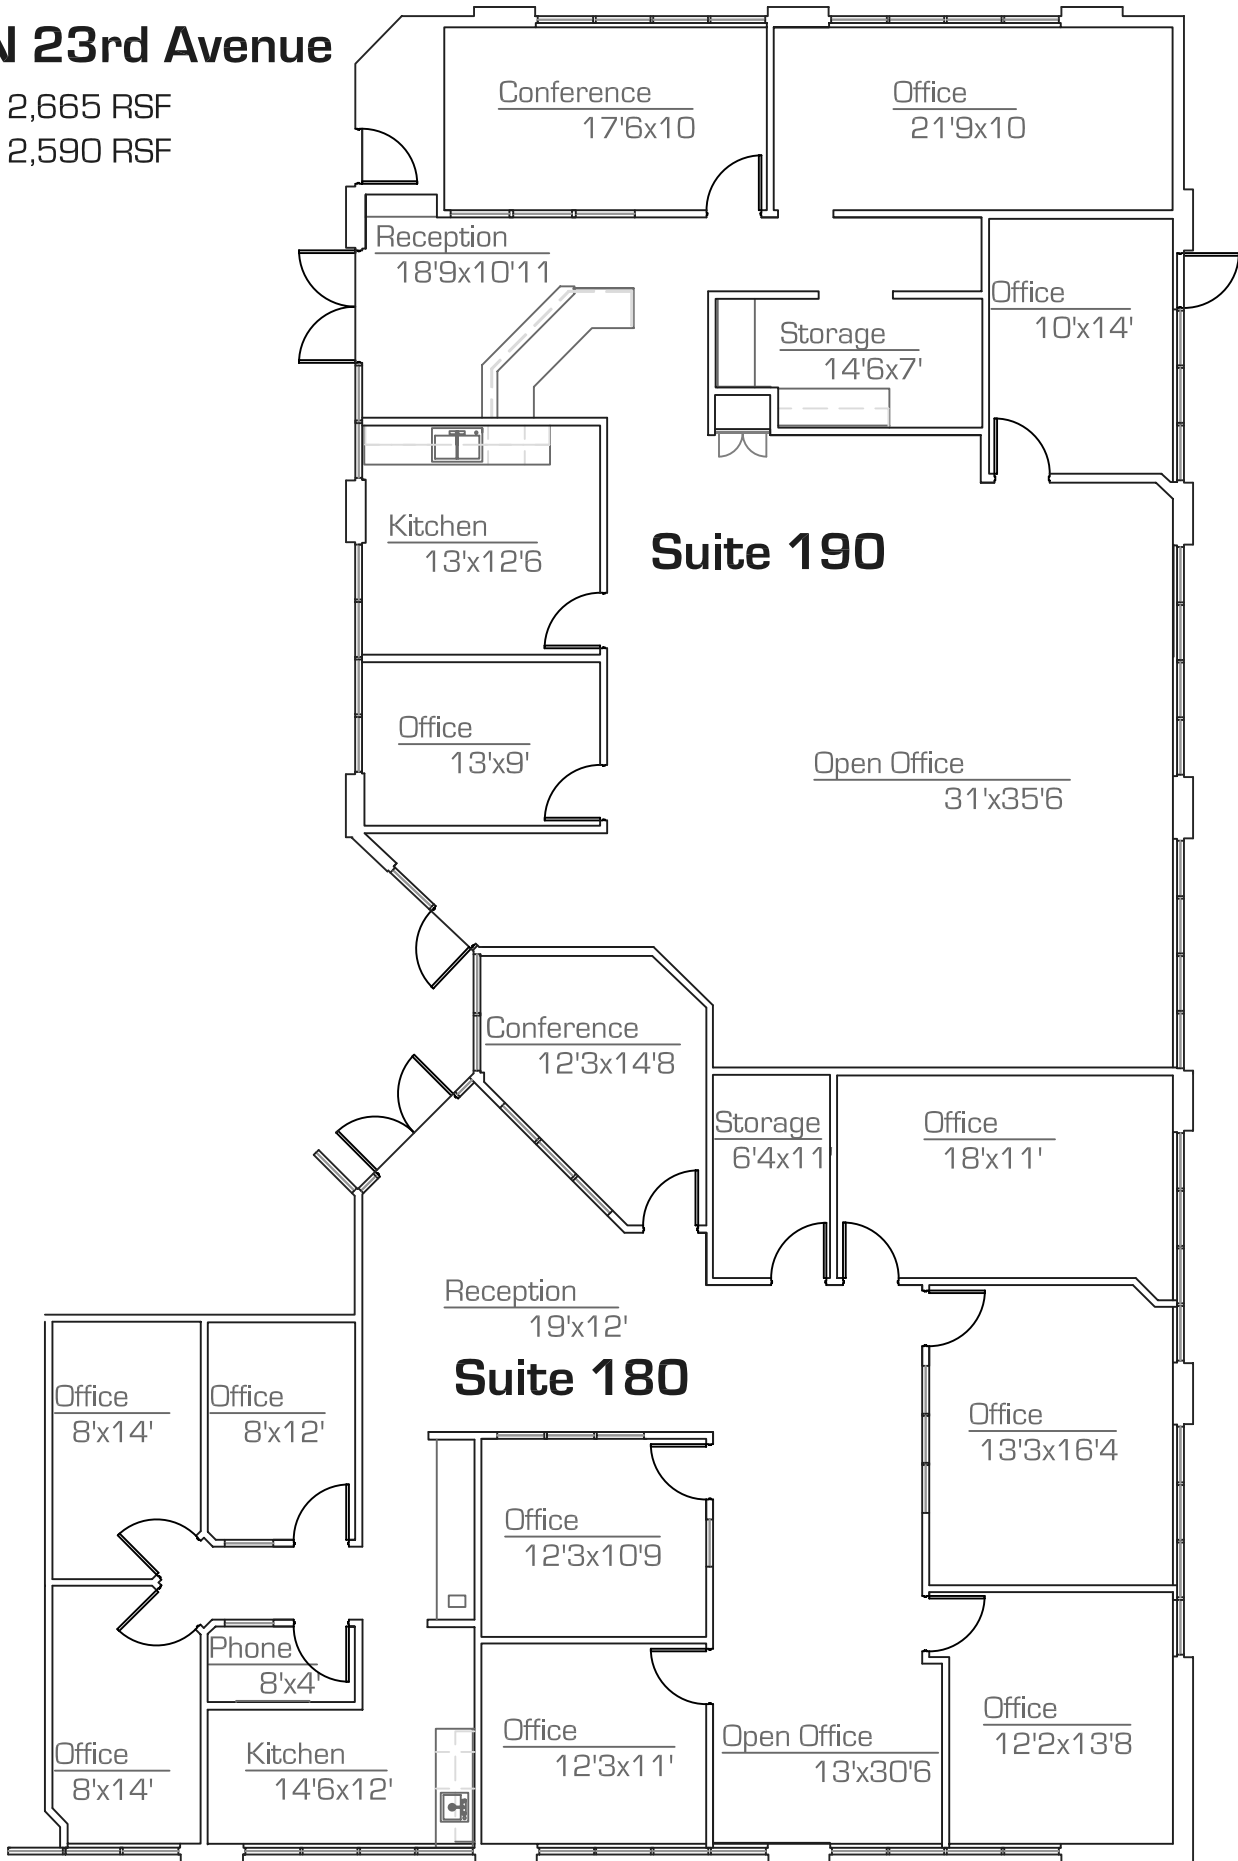


**as-built**

scale: nts  
22.June.2007

\*All dimensions are approximate  
\*All information is of general nature

precision**MEASUREMENTS**

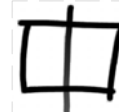

as built . space plans  
architectural design

602.790.6412