


8805 N 23rd Ave

Suite 180 - 2,665 RSF

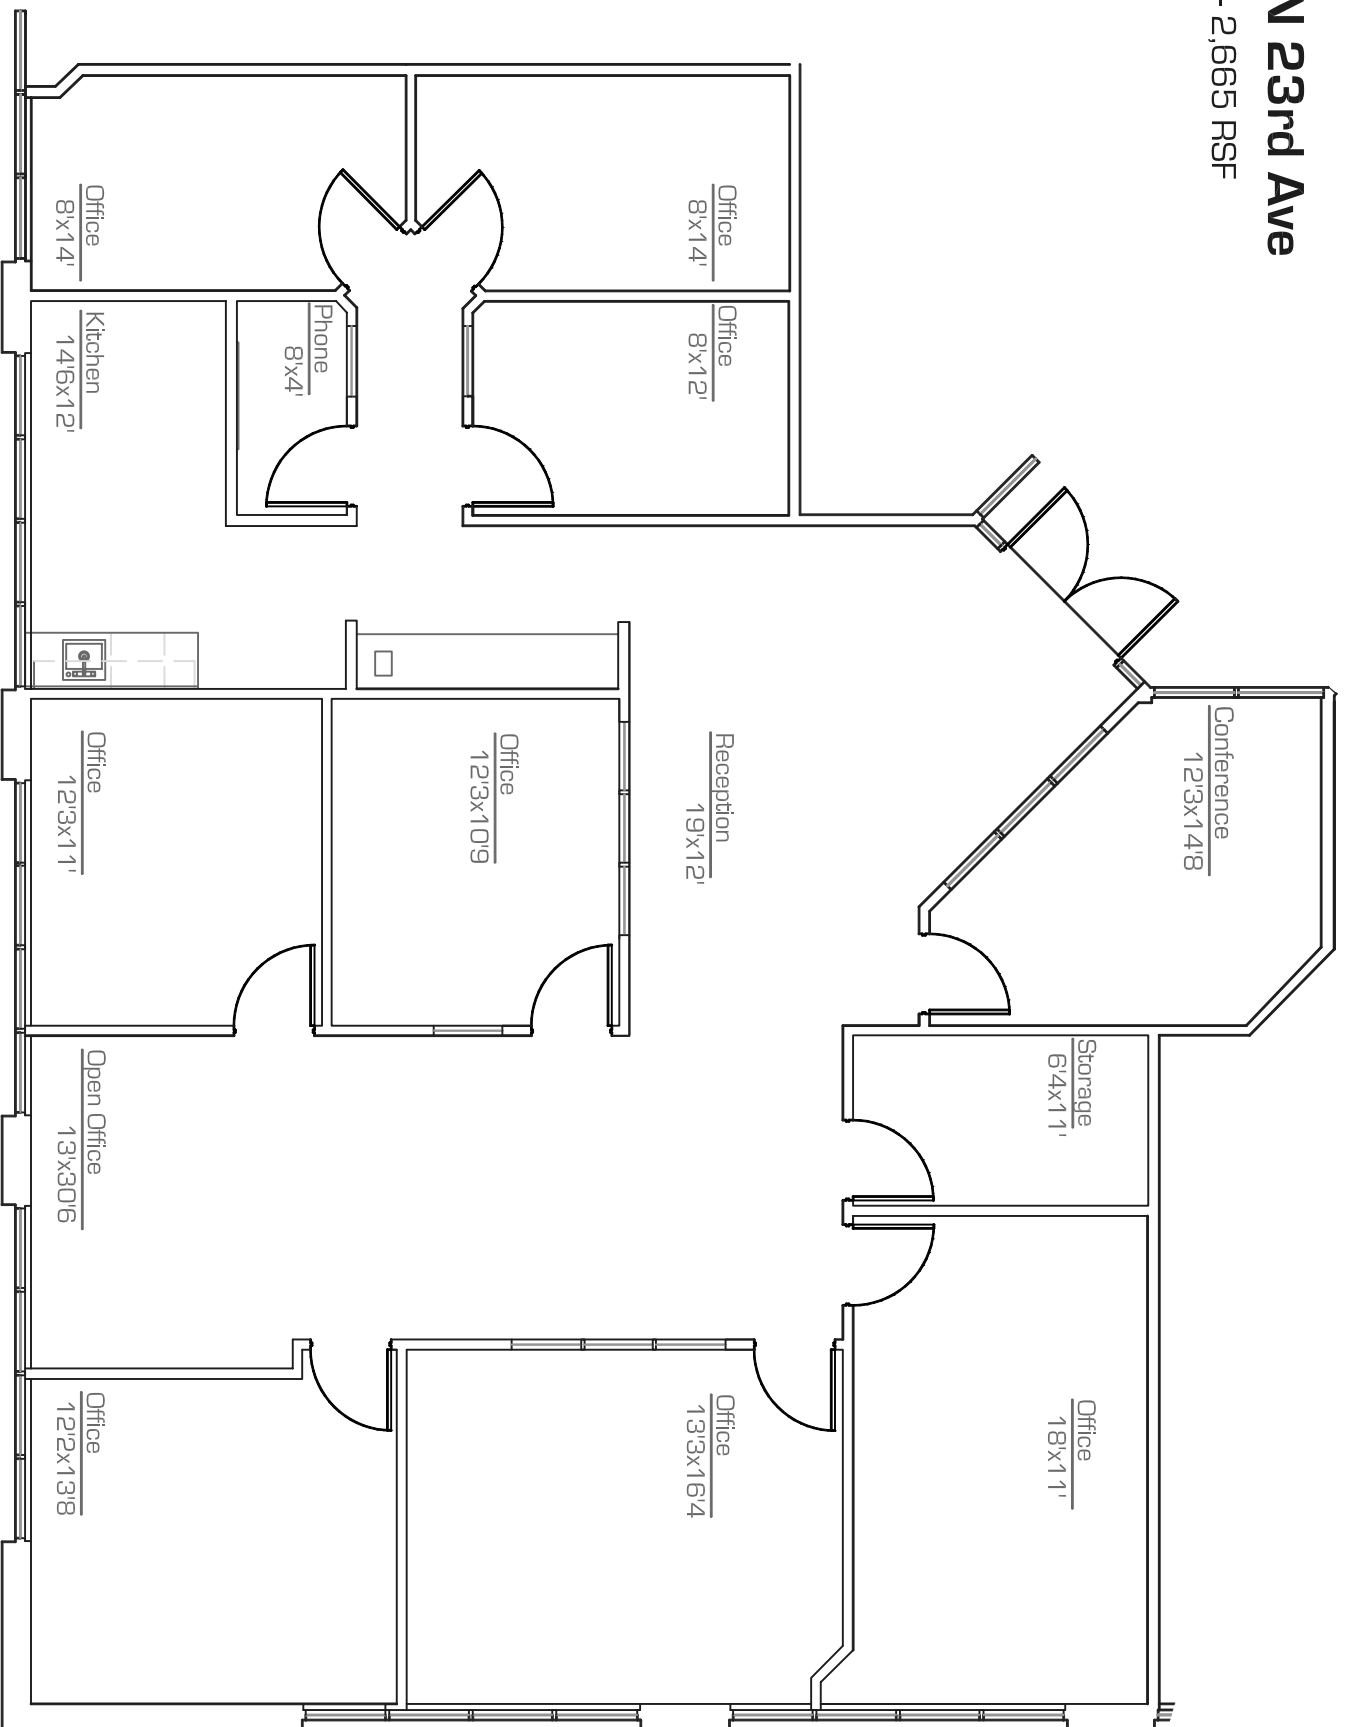

as-built

scale: nts
22.June.2007

* All dimensions are approximate
* All information is of general nature



precision **MEASUREMENTS**



as built, space plans
architectural design
602.790.6412